


SITE PLAN Ref 20140102-5

DCK 6/4/14

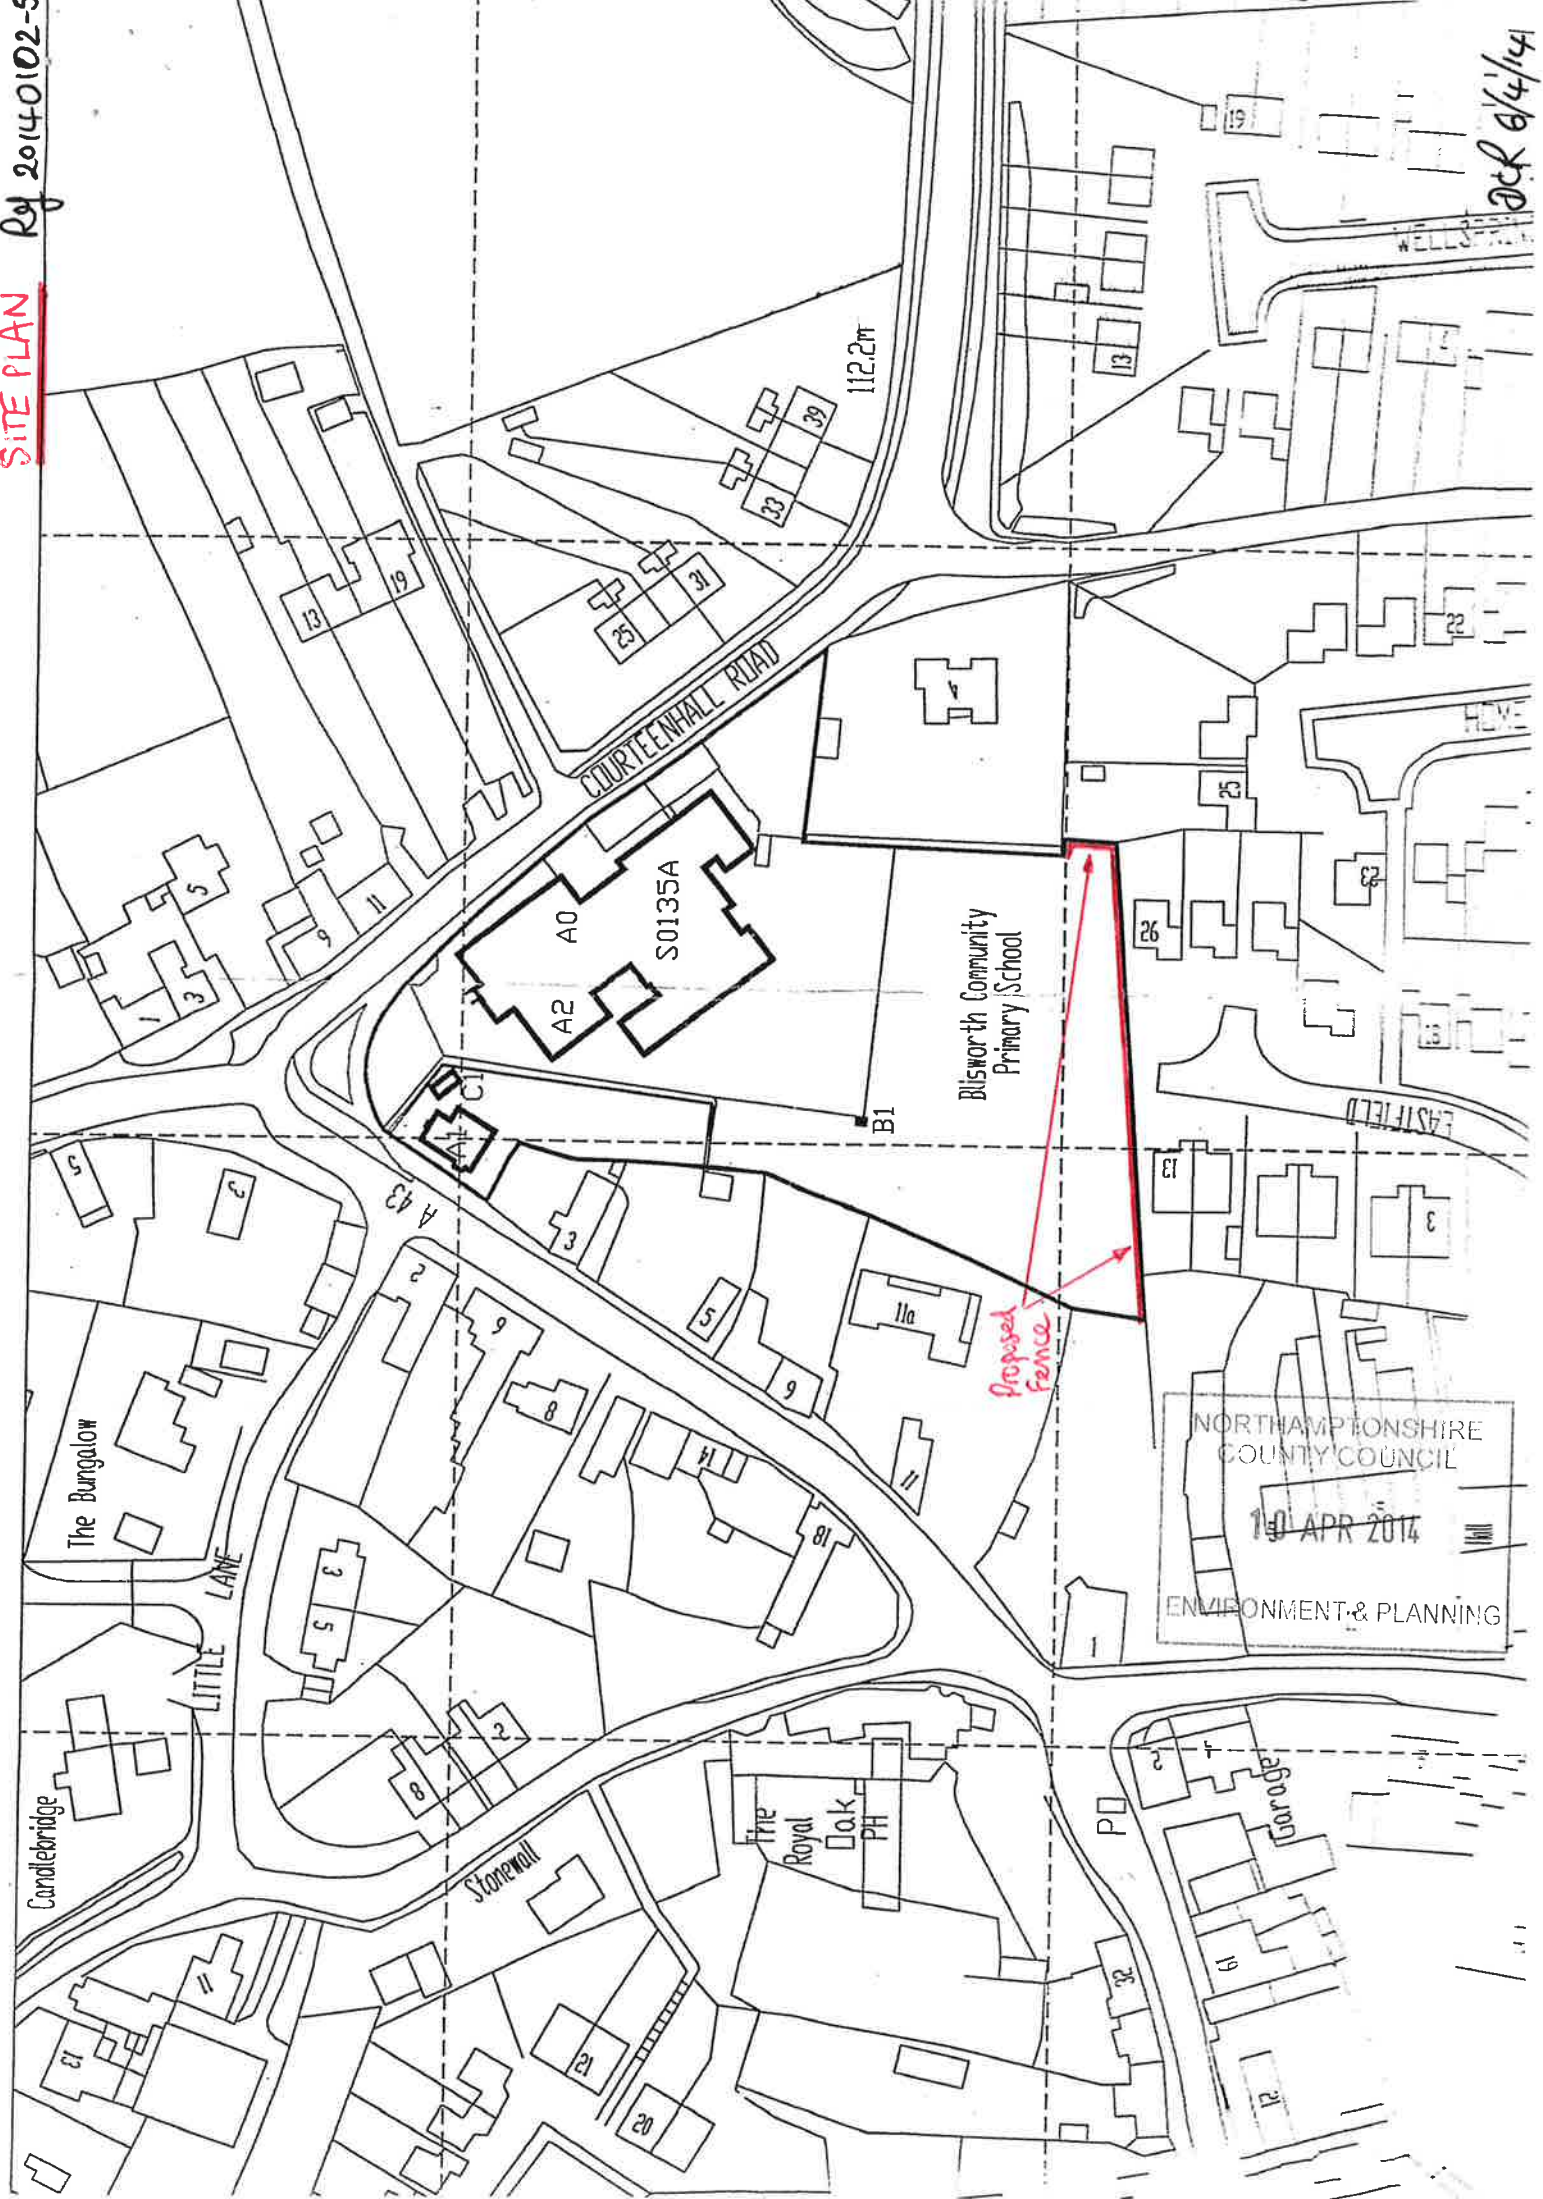



NORTHAMPTONSHIRE COUNTY COUNCIL
10 APR 2014
ENVIRONMENT & PLANNING

Scale 1:100

Existing Elevation

Ref 2014 0102 - 1

House
26 Eastfield
Blisworth

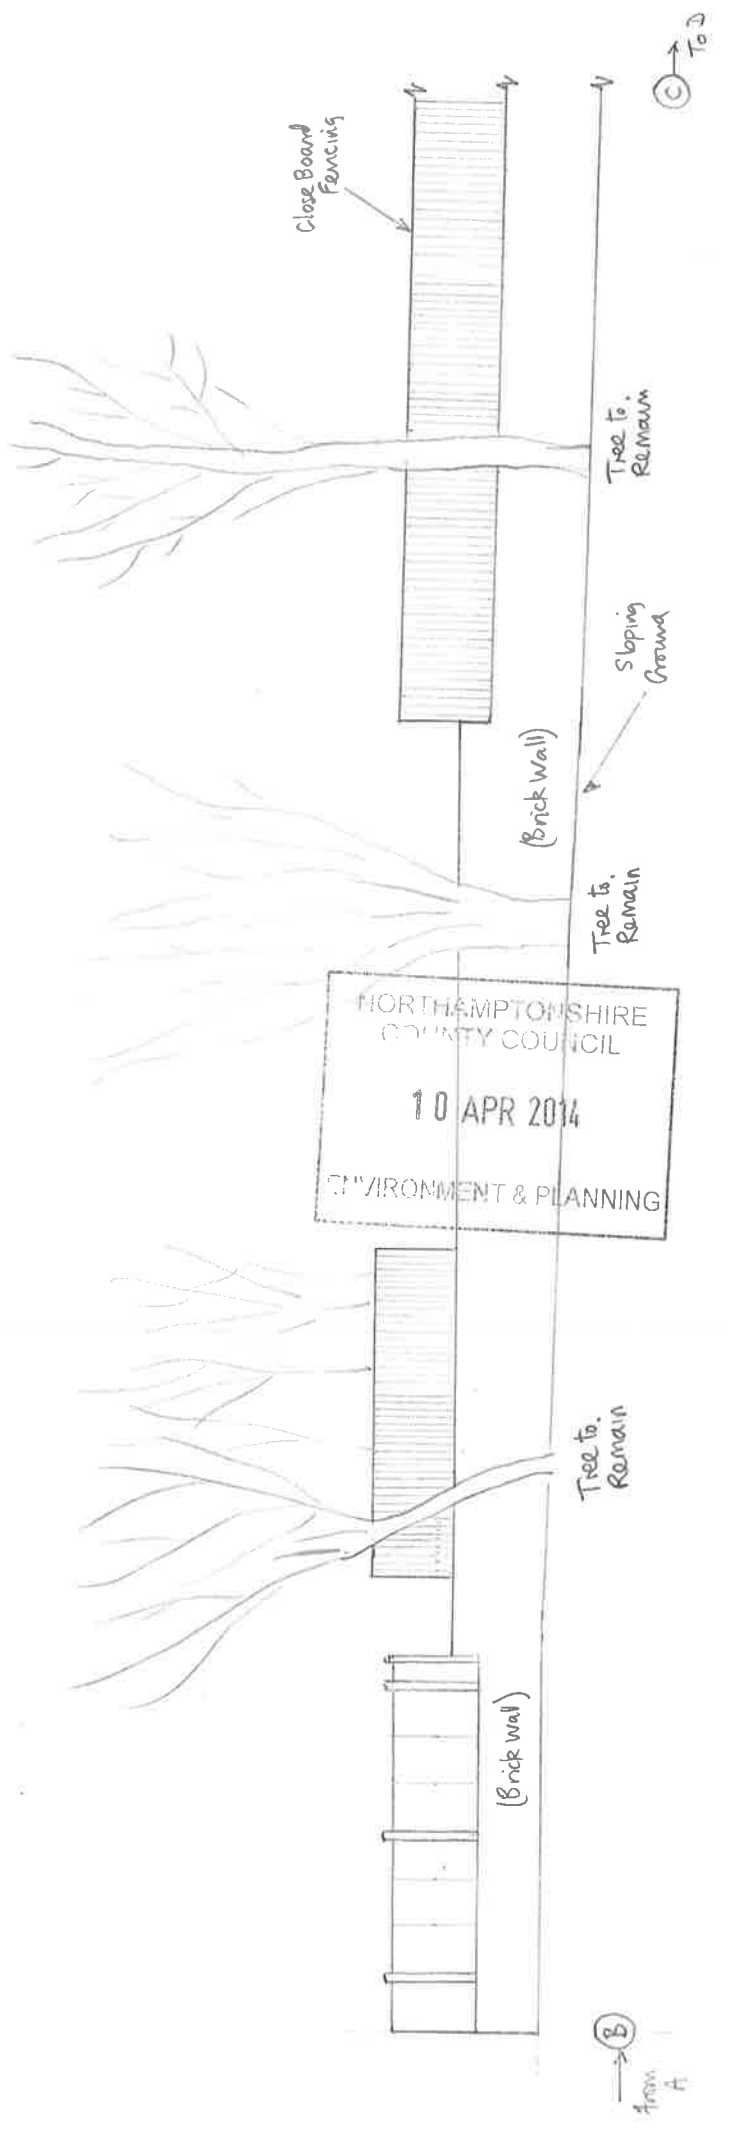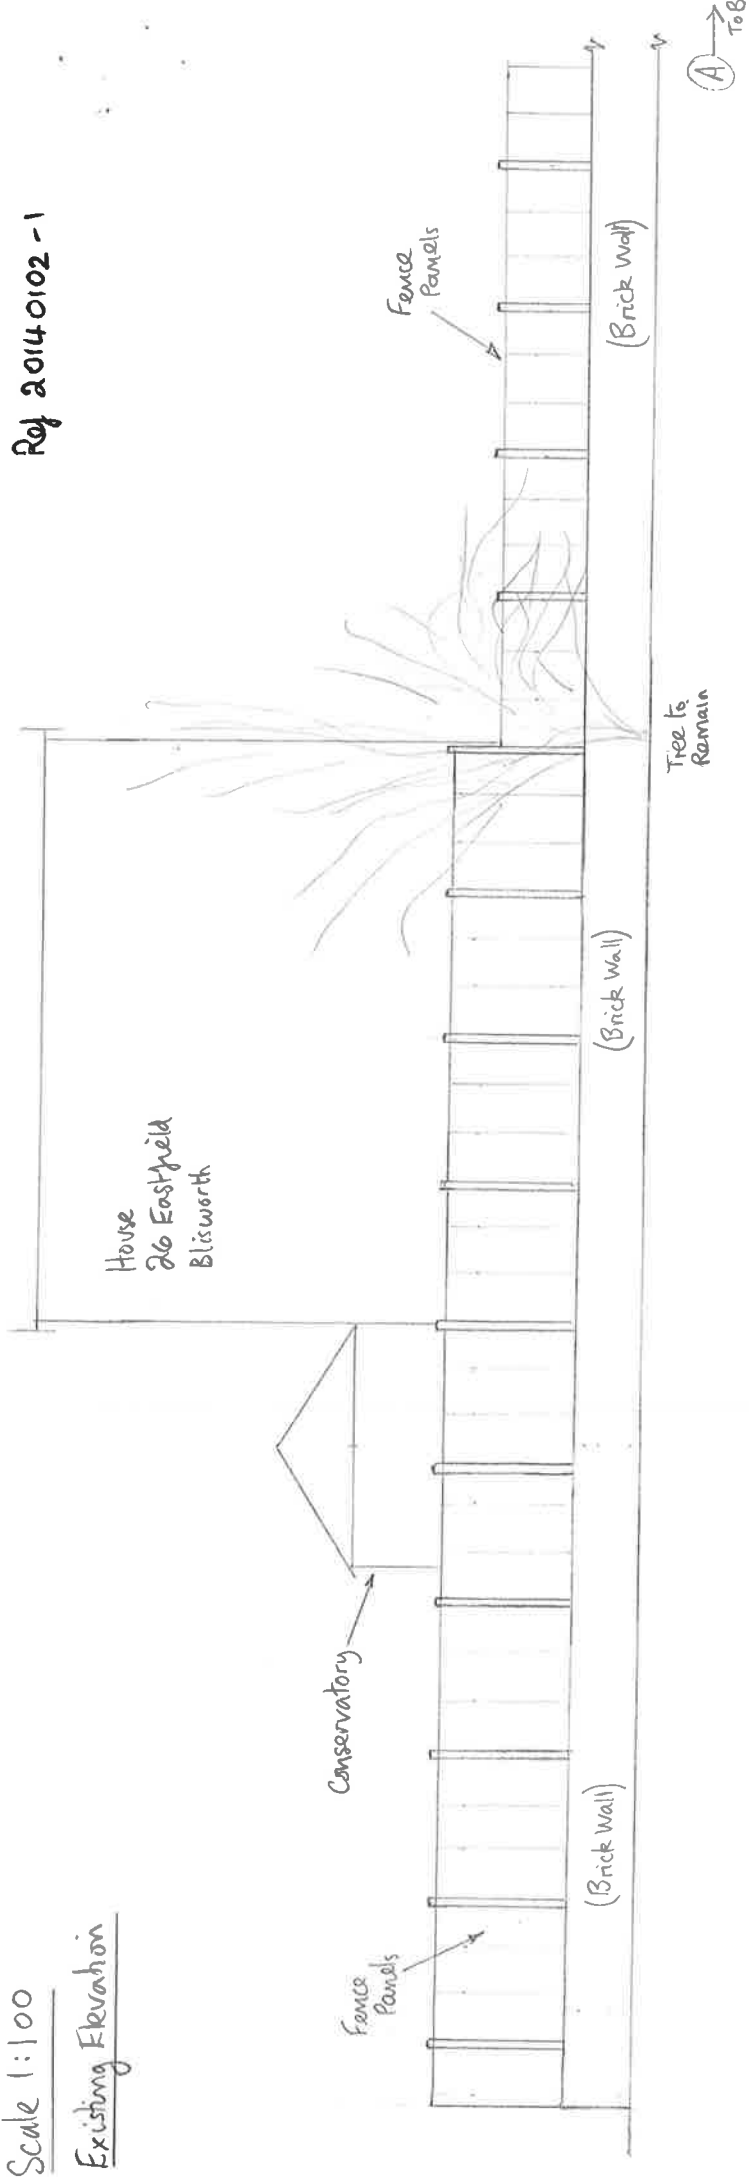

NORTHAMPTONSHIRE COUNTY COUNCIL


10 APR 2014

ENVIRONMENT & PLANNING

JCR 6/4/14

Ref 20140102-2

Scale 1:100

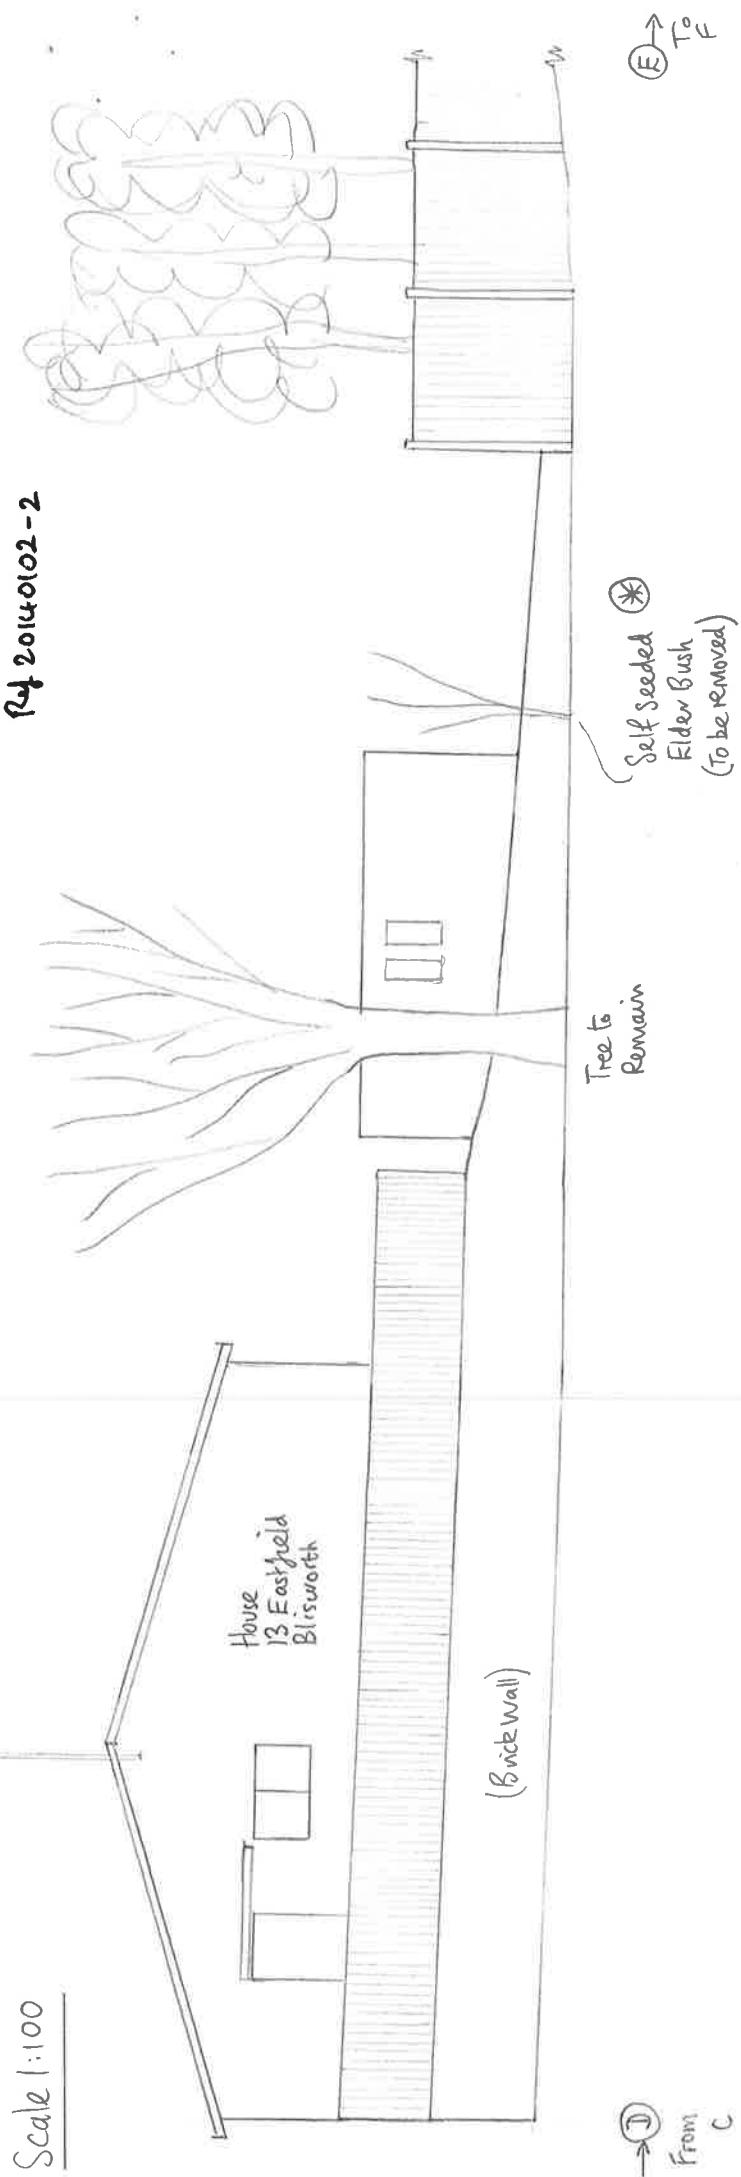

NORTHAMPTONSHIRE
 COUNTY COUNCIL

10 APR 2014

ENVIRONMENT & PLANNING



From E

Dec 6/4/14

Scale 1:100

Proposed Elevation (with new fence shown in green)

Ref 20140102-3

House
26 Eastfield
Blunworth

Conservatory

Fence Panels

Fence Panels

(Brick Wall)

(Brick Wall)

(Brick Wall)

Tree to Remain

A → To B

Close Board Fencing

(Brick Wall)

(Brick Wall)

Tree to Remain

Tree to Remain

Tree to Remain


Sloping Ground

C → To D

B → From A

NORTHAMPTONSHIRE
COUNTY COUNCIL
10 APR 2014
ENVIRONMENT & PLANNING

DCL 6/4/14

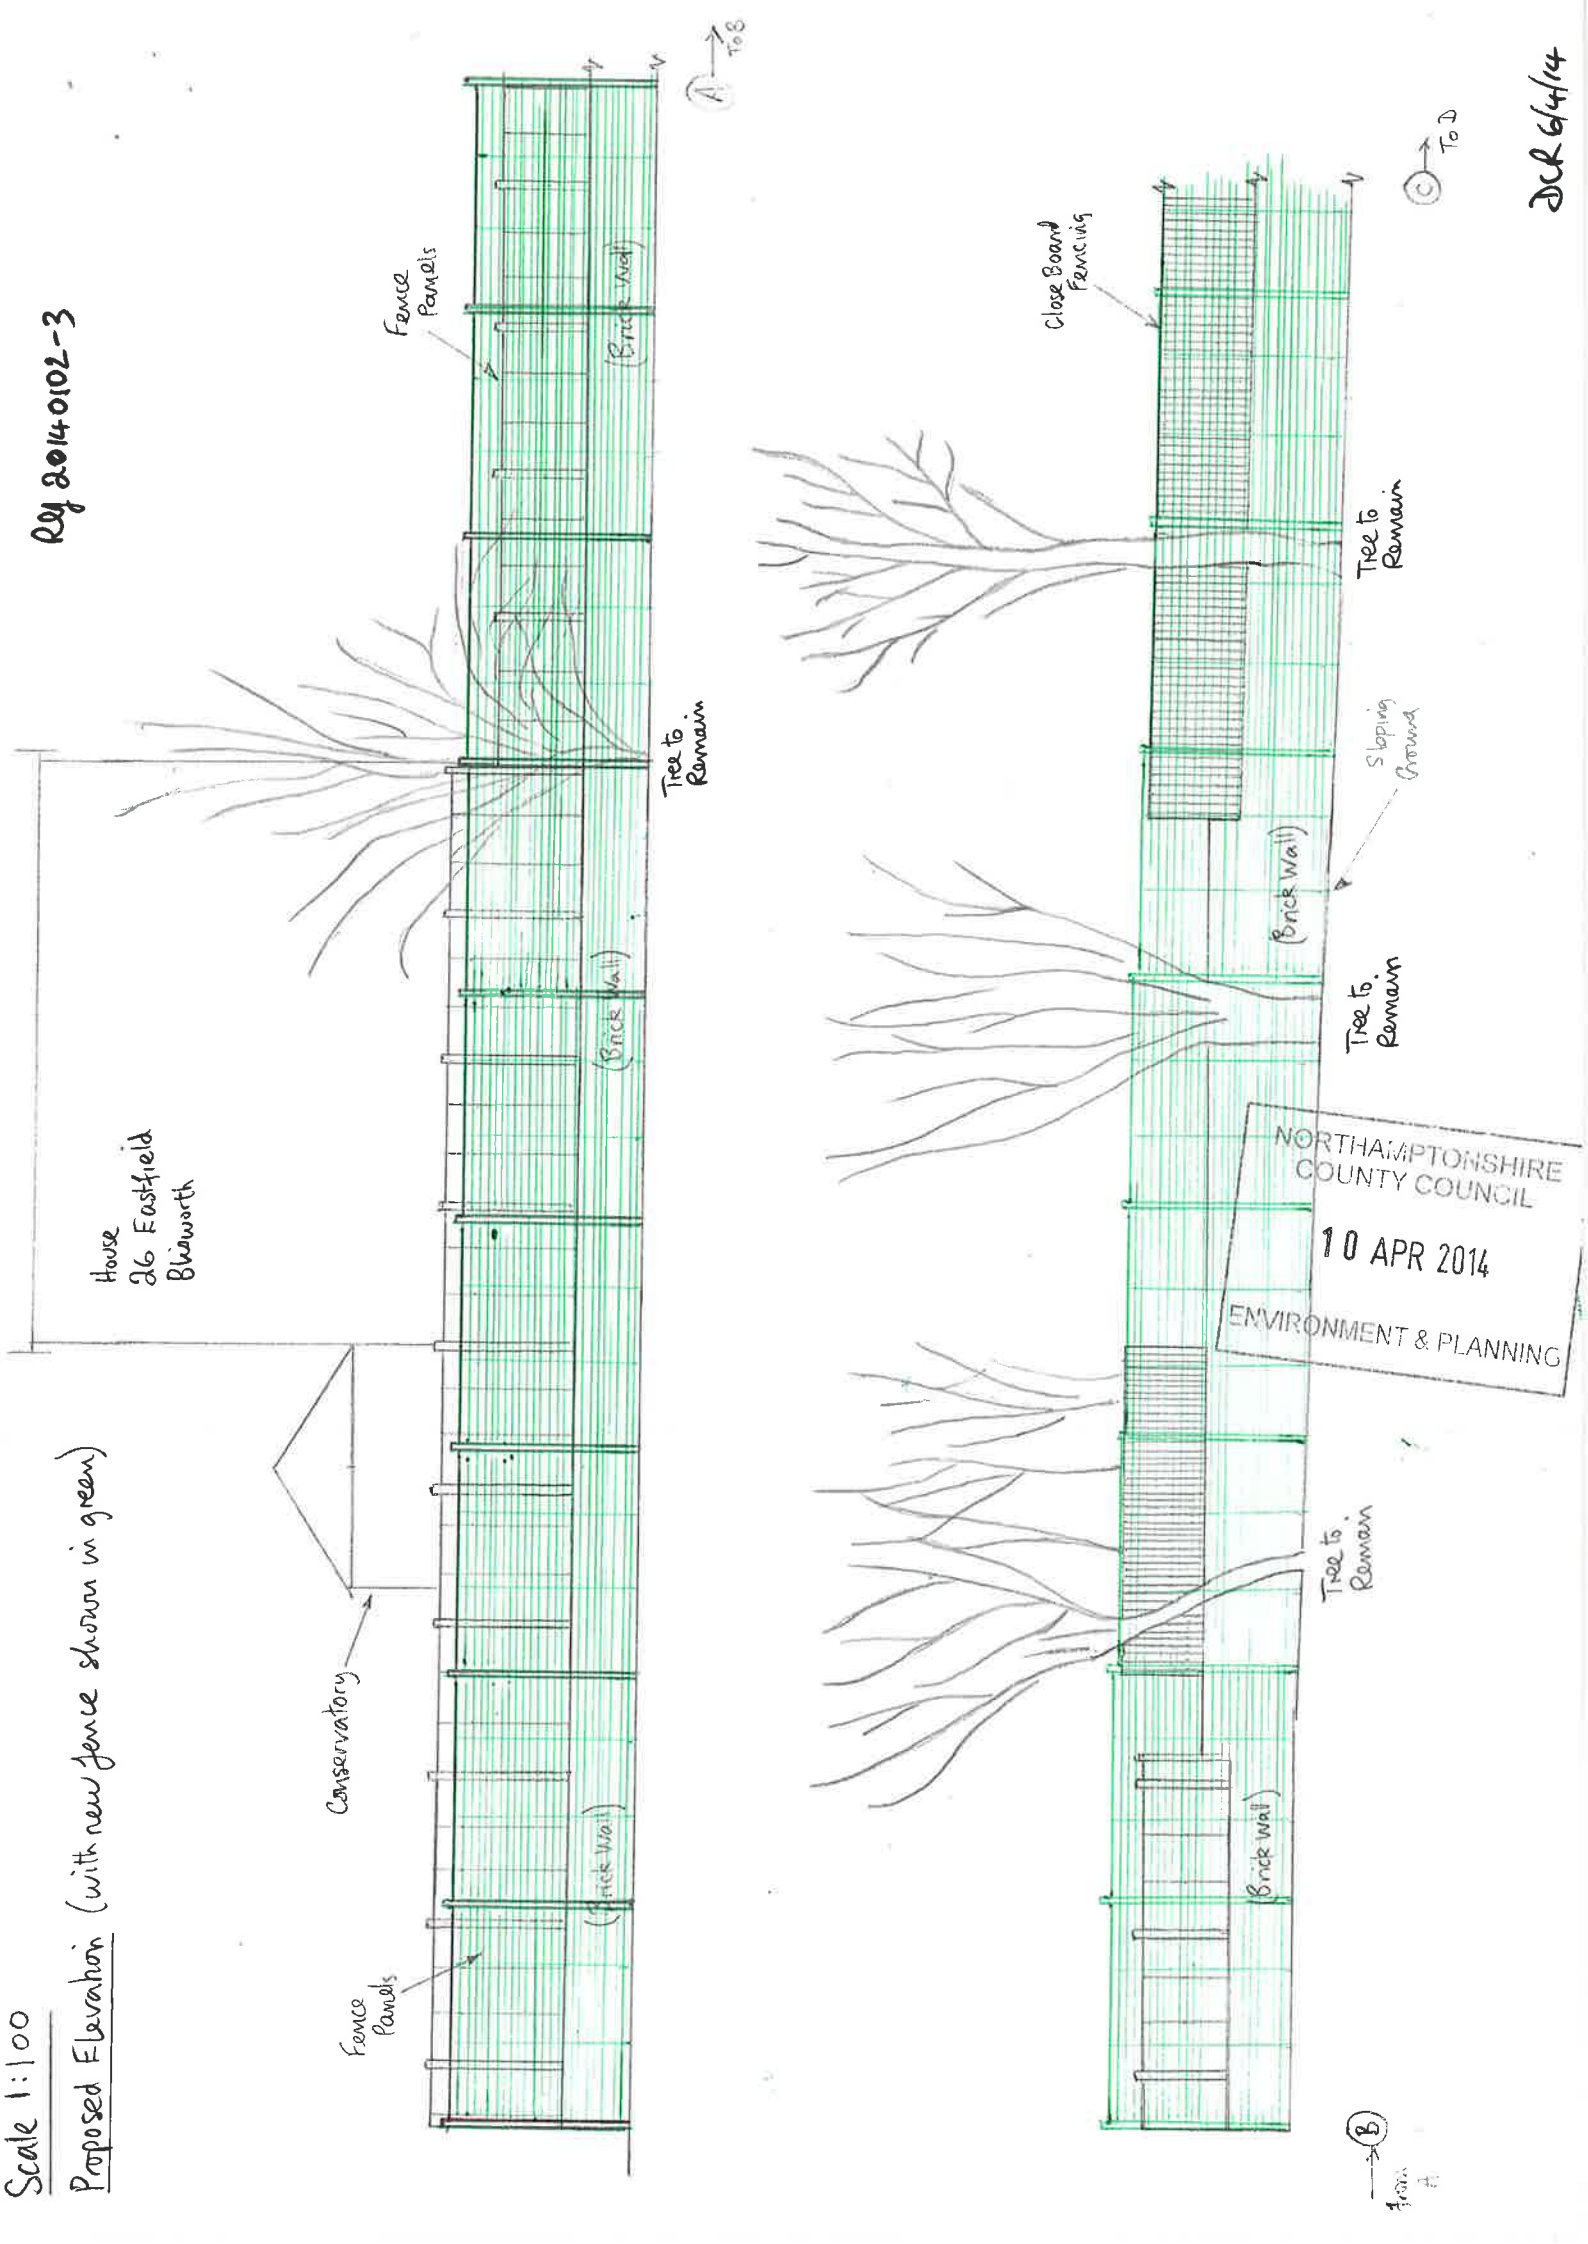

Scale 1:100

Ref 2014 0102-4

House
13 Eastfield
Blisworth

(Back wall)


Tree to
Remain

Self seeded
Elder Bush
(To be removed)

(E) →
To F

→ (D)
From C

NORTHAMPTONSHIRE
COUNTY COUNCIL
10 APR 2014
ENVIRONMENT & PLANNING

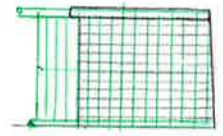

(F) →
From E

DCR 6/4/14

